


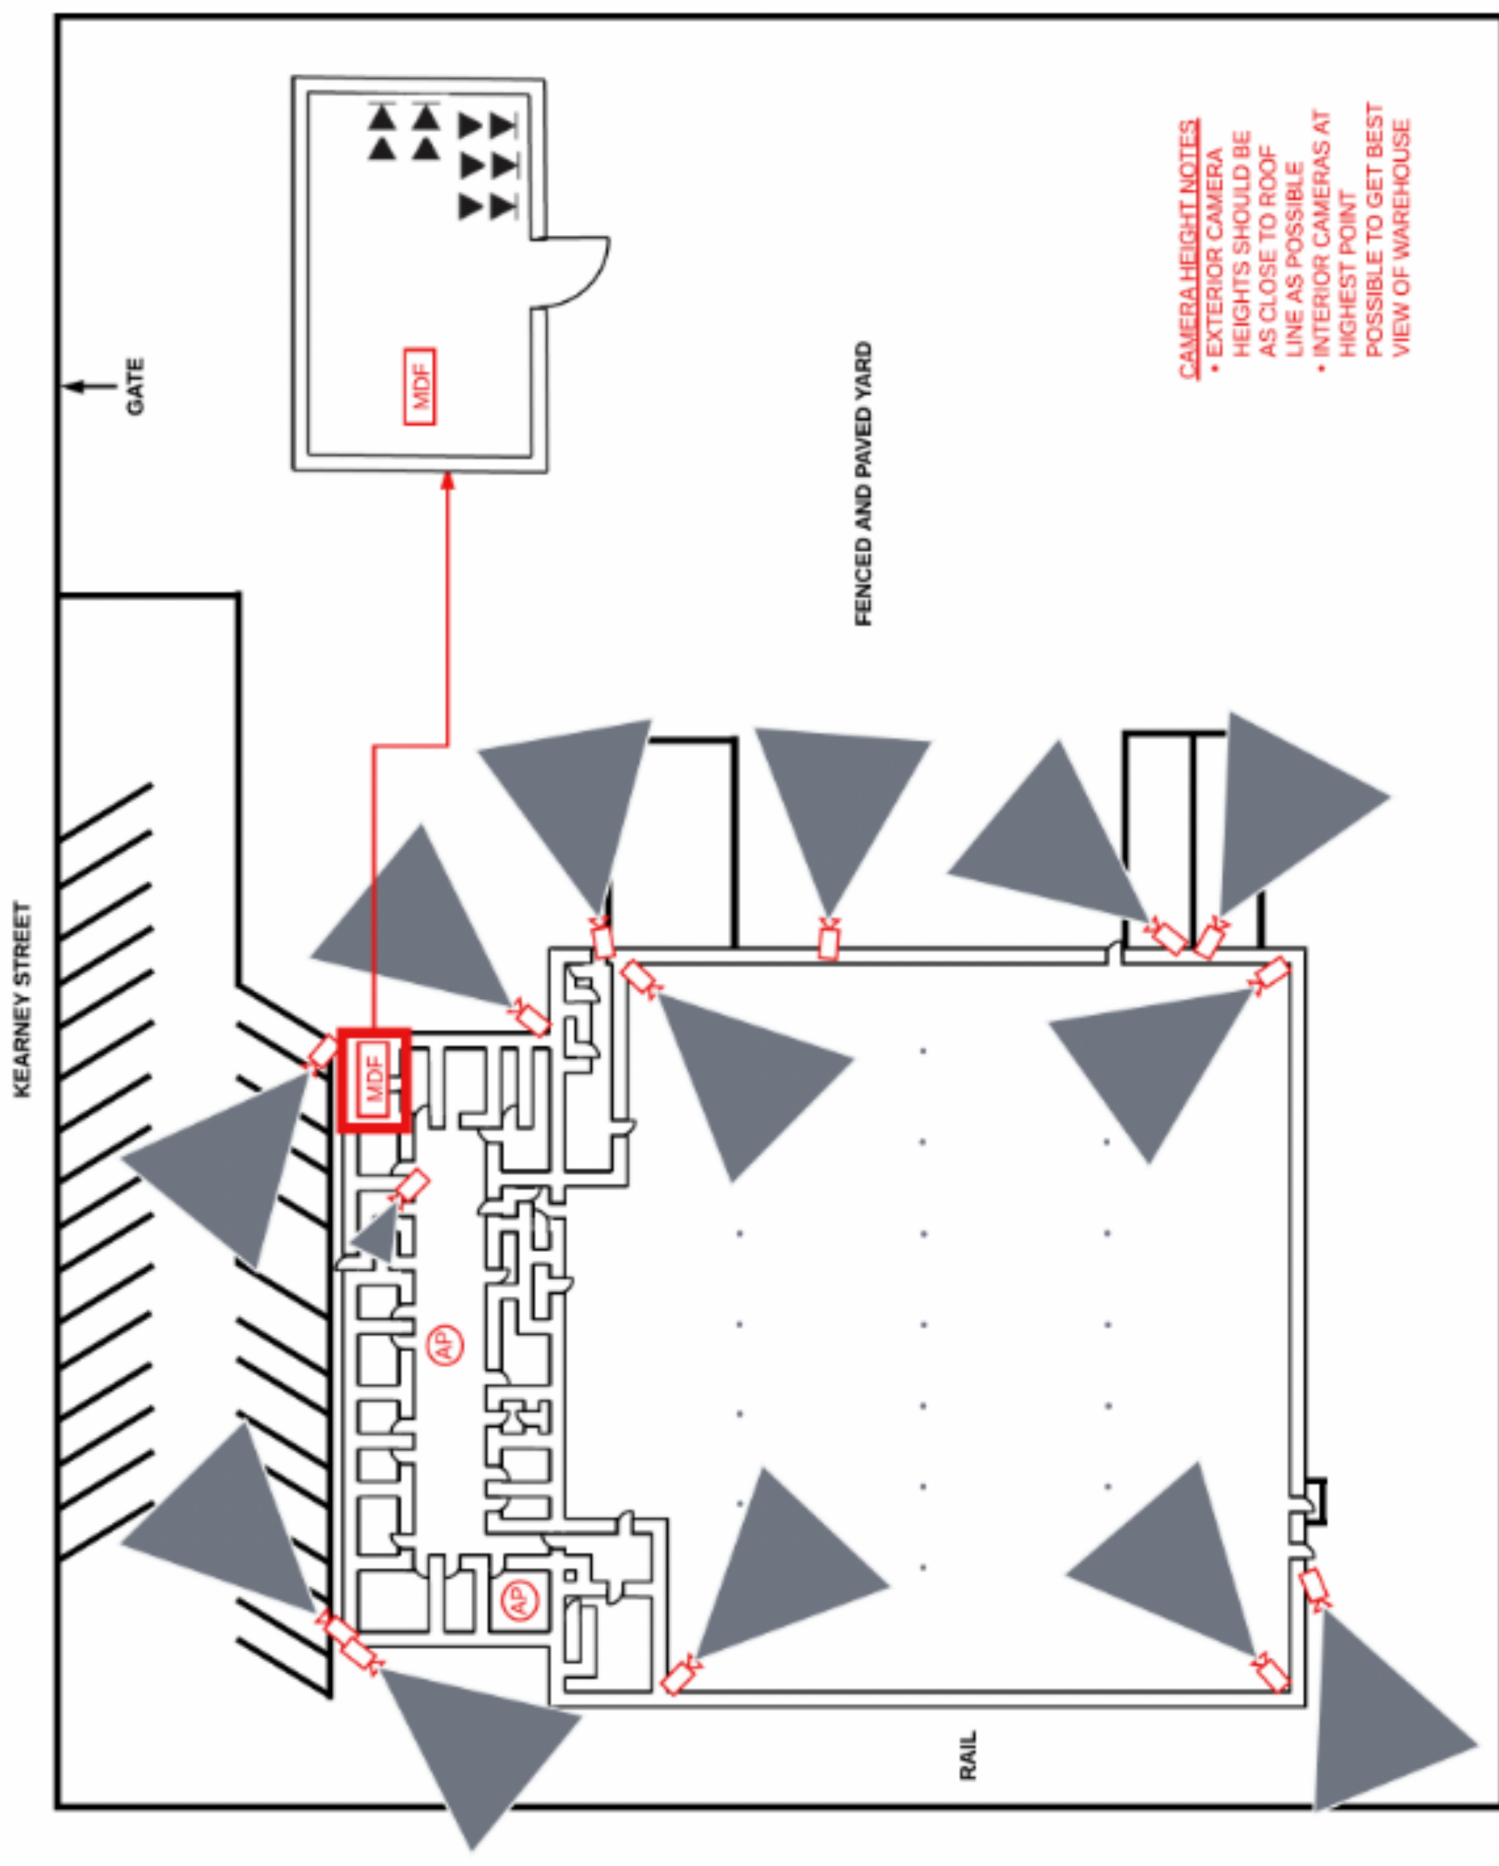

AS BUILT