



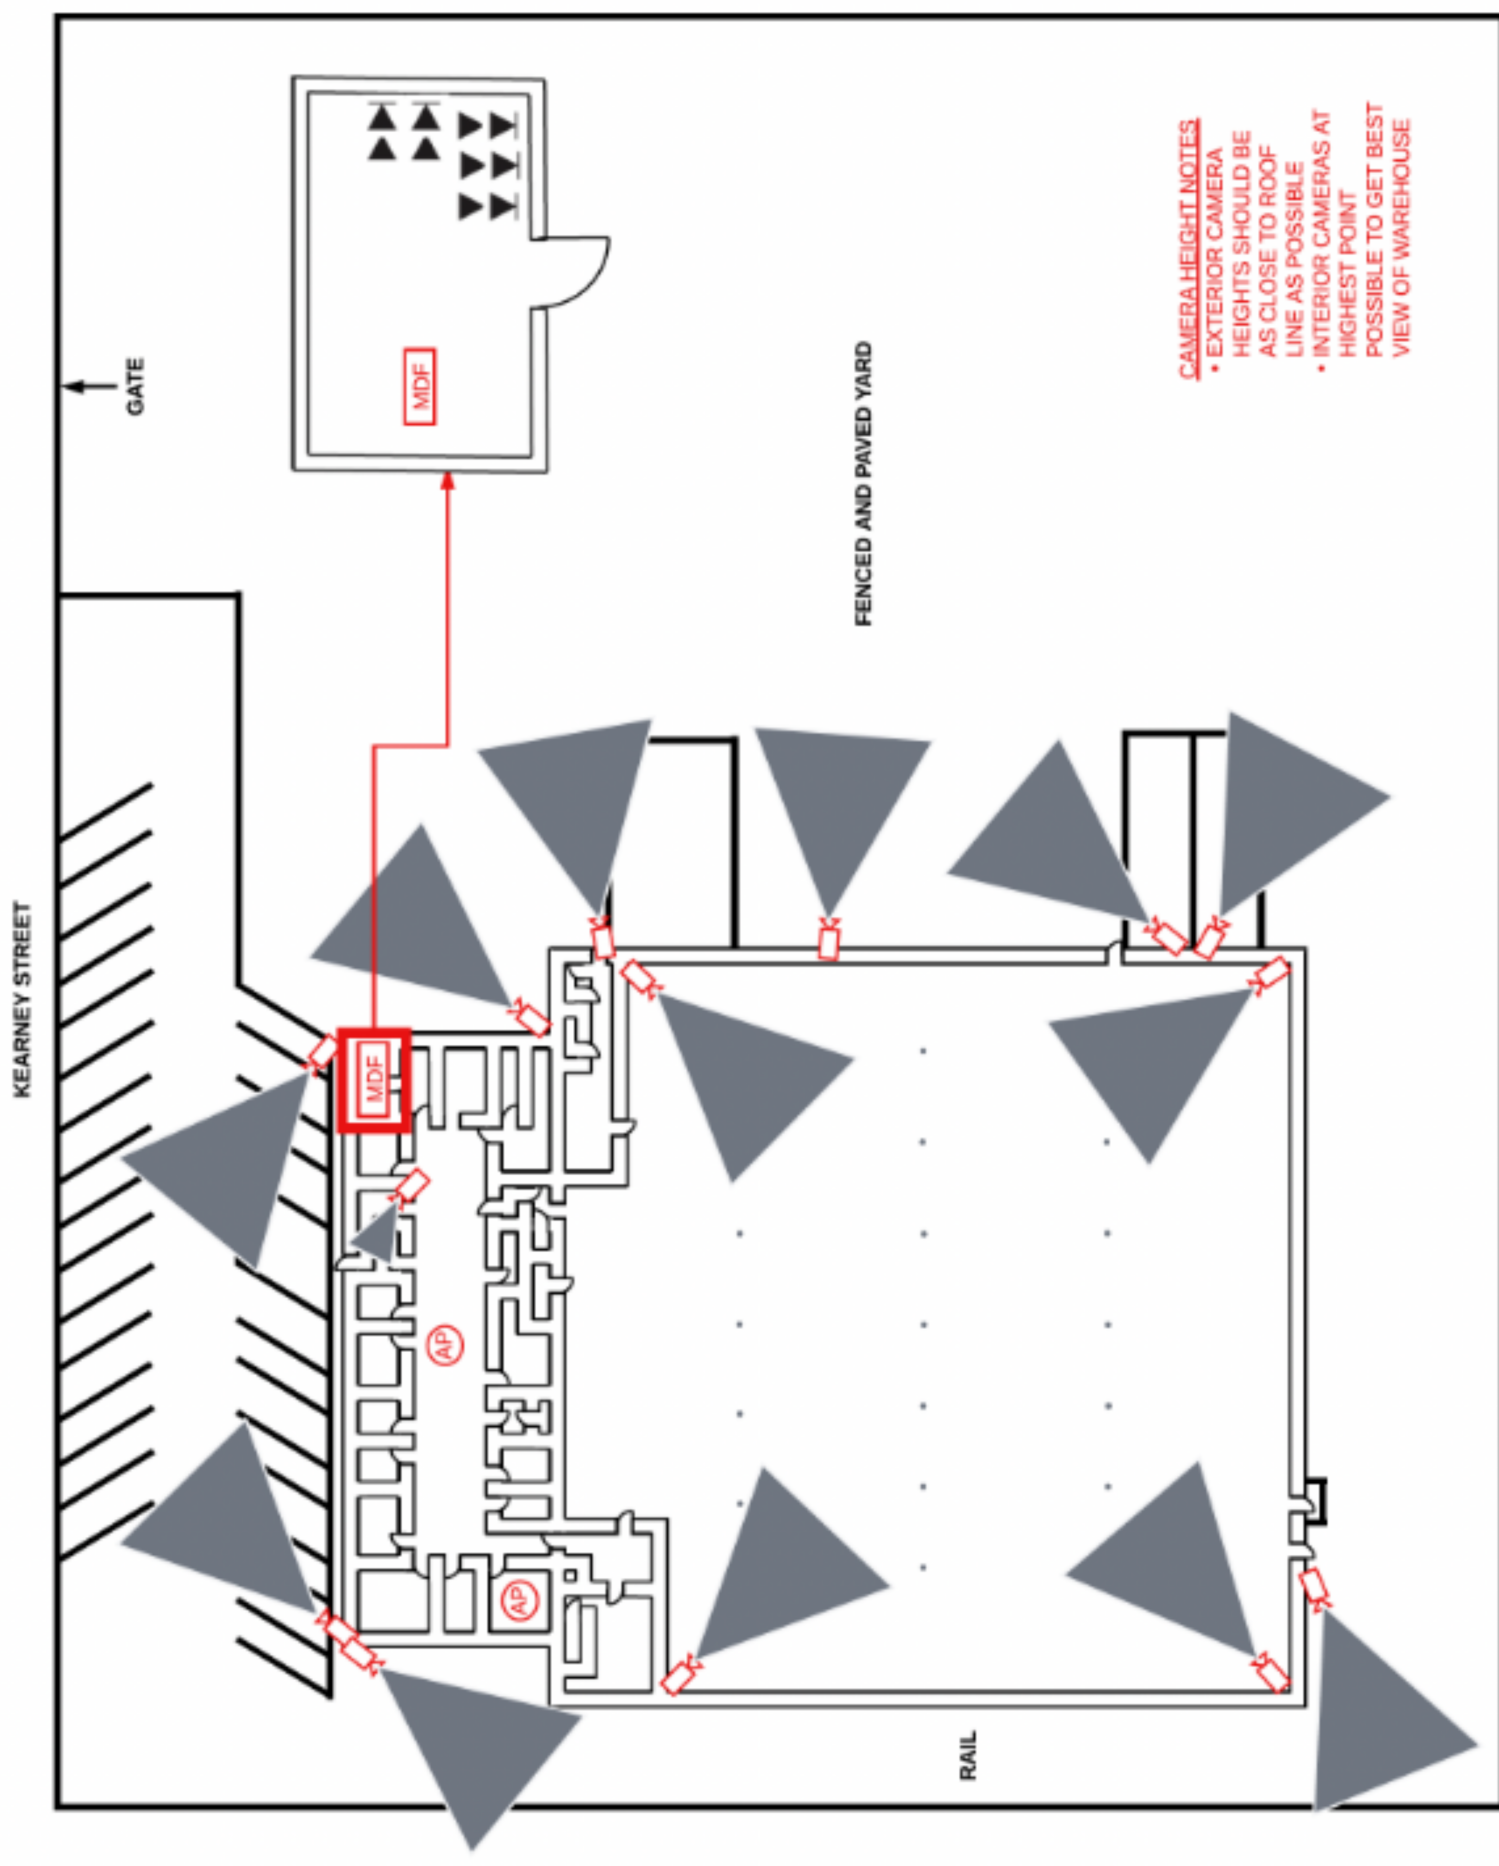

AS BUILT

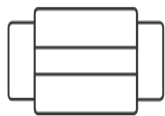

MDF-1

R1