

















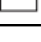


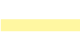

 
	Single Data Drop
	Dual Data Drop
	Triple Data Drop
	Quad Data Drop
	Fiber Panel
	Minimum Point of Entry (Carrier MPOE)
	Main Distribution Frame
	Independent Distribution Frame
	Ceiling Mounted Data Drop
	IT Rack Location
	Point to Point

	Directional Camera
	Omni Directional Camera
	Horn
	Junction Box
	Television
	Card Reader
	Wireless Access Point
	Ground Bus Bar
	Above Finished Floor
	Conduit
	OS2 Fiber
	OM4 Fiber
	OM3 Fiber
	CAT6

LEGEND

SCALE: NTS

LEGEND

NOTE:
DRAWINGS, SYMBOLS
AND/OR ANNOTATIONS
MAY NOT BE TO SCALE,
AND ARE PORTRAYED
FOR REPRESENTATIONAL
PURPOSES ONLY.
ACTUAL SIZES AND/OR
DESIGN MAY DIFFER.

REVIEWED BY:
CRIS PHELPS, PMP, RCDD





CONFIDENTIAL - NOT TO BE SHARED

SITE PLAN

SCALE: NTS

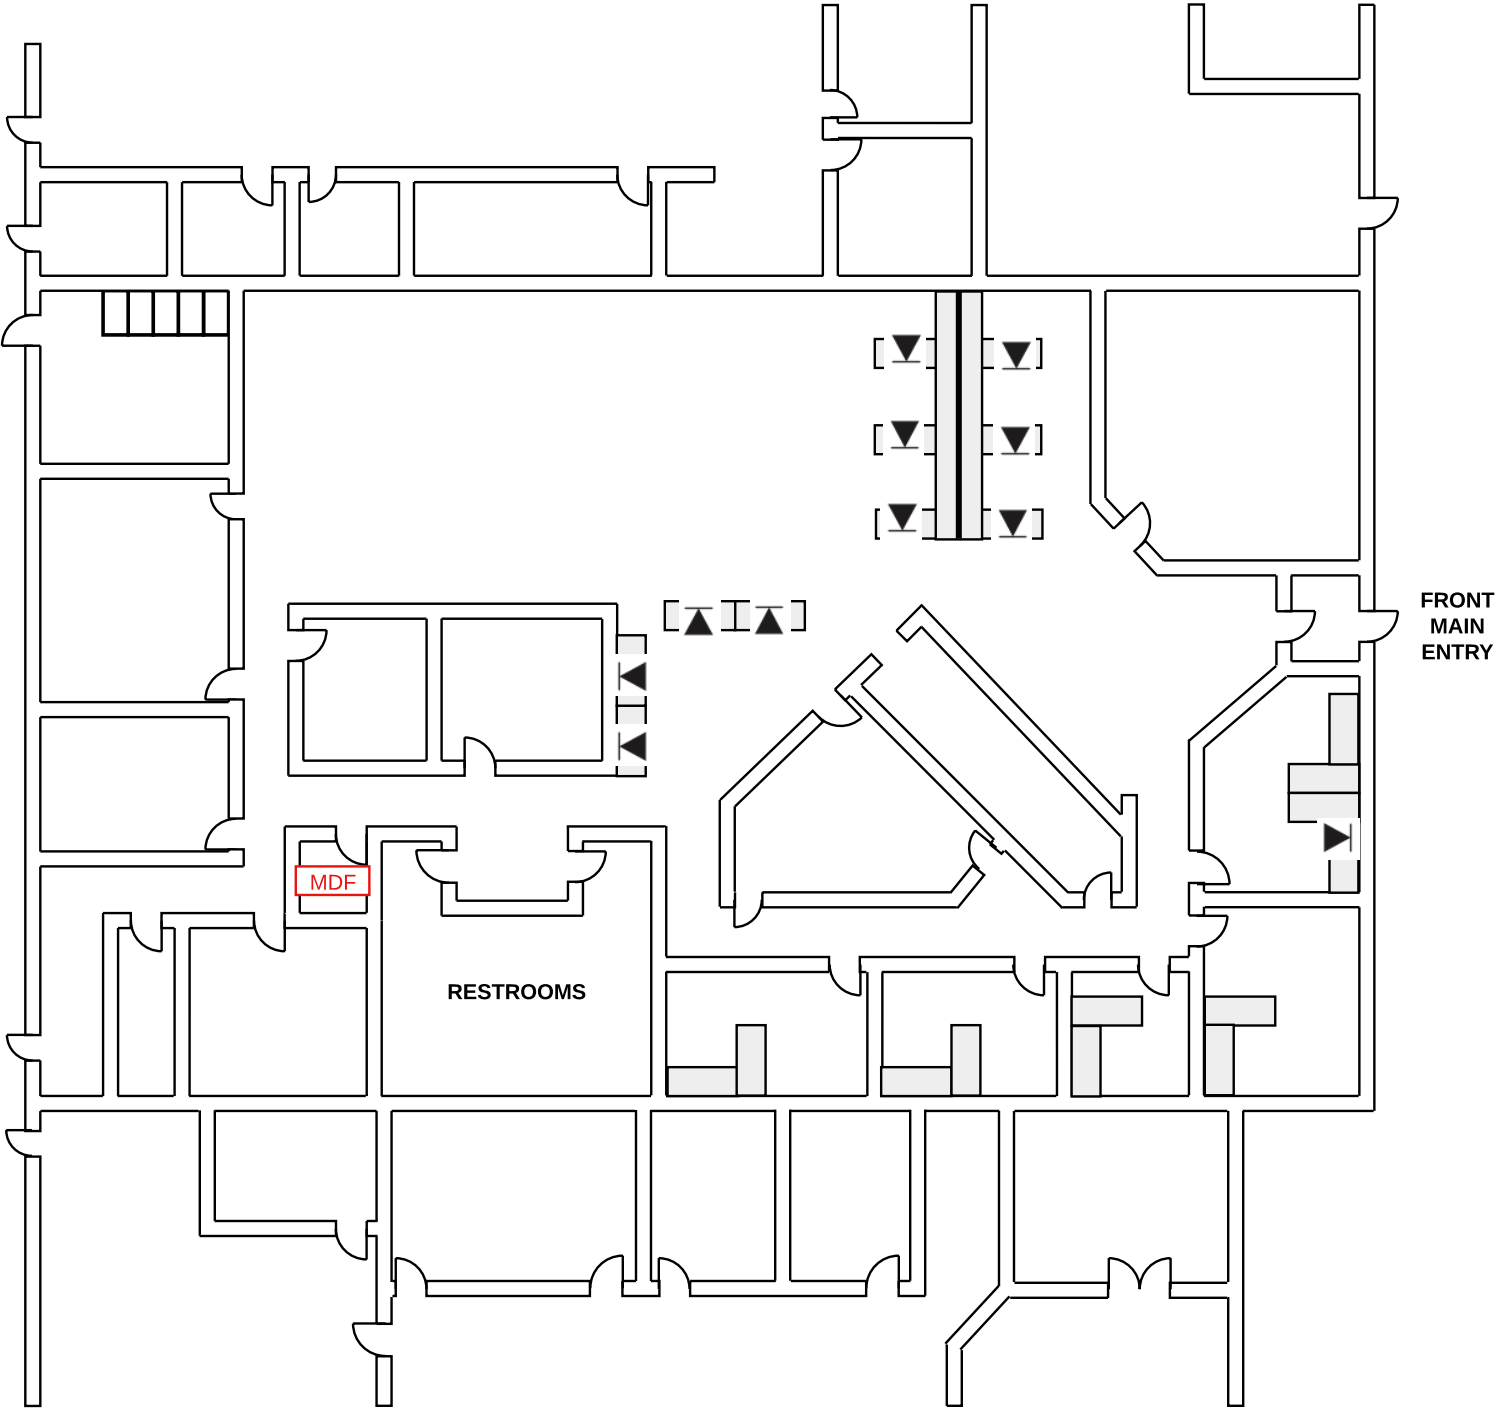
NATIONWIDE SCS
PO Box 4018
Plymouth MA
02361

SITE PLAN

NOTE:
DRAWINGS, SYMBOLS
AND/OR ANNOTATIONS
MAY NOT BE TO SCALE,
AND ARE PORTRAYED
FOR REPRESENTATIONAL
PURPOSES ONLY.
ACTUAL SIZES AND/OR
DESIGN MAY DIFFER.

REVIEWED BY:
CRIS PHELPS, PMP, RCDD





NATIONWIDE SCS

PO Box 4018
Plymouth MA
02361

Revision History

AS BUILT / LABELING

NOTE:

DRAWINGS, SYMBOLS
AND/OR ANNOTATIONS
MAY NOT BE TO SCALE,
AND ARE PORTRAYED
FOR REPRESENTATIONAL
PURPOSES ONLY.
ACTUAL SIZES AND/OR
DESIGN MAY DIFFER.

REVIEWED BY:
CRIS PHELPS, PMP, RCDD
(617) 500 - 1252

Bicsi

CRIS A. PHELPS

REGISTERED COMMUNICATIONS DISTRIBUTION DESIGNER

REGISTERED IN MA

RCDD

CONFIDENTIAL - NOT TO BE SHARED

AS BUILT
SCALE: NTS



- New LV drop
- New j-box location for cubes
- Exist LAN Room location

EXISTING _____
DRIVE-IN DOOR IN-FILLED
WITH GLASS

EXISTING ———
DRIVE-IN DOOR

EXISTING
DEMISING
WALL

#170 L
-PREMIERE COPY
3,778 S.F.

0'-0" CEILING
HEIGHT !!

EXISTING
DEMISING
WALL

This area part of
Tenant Alterations
Scope

—FRONT
MAIN
ENTRY

#190
— SYLVESTER'S —
MAINTENANCE &
MECHANICAL
5.506 S.F.

Securitas Proposed Remodel
Rev 2 3/2/2023
7442 South Tucson Way, Suite 180
Centennial, CO

(5,898 RSF)

Scale: $\frac{1}{4}$ " = 10'

Legend:

Demolition of existing walls & stairs.

NATIONWIDE SCS

PO Box 4018
Plymouth MA
02361

CUSTOMER PROVIDED FLOOR PLAN
8.24.2023

NOTE:

**DRAWINGS, SYMBOLS
AND/OR ANNOTATIONS
MAY NOT BE TO SCALE,
AND ARE PORTRAYED
FOR REPRESENTATIONAL
PURPOSES ONLY.
ACTUAL SIZES AND/OR
DESIGN MAY DIFFER.**

REVIEWED BY:

CRIS PHELPS, PMP, RCDD

Bicsi
Cris A Phelps
BICSID #248229
EXPIRES 12-31-23

CONFIDENTIAL - NOT TO BE SHARED

CUSTOMER PROVIDED FLOOR PLAN

SCALE: NTS