


**RECORD
DOCUMENTS**

Please do not photocopy, have been
inserted and good information
limited-up print, drawings and other
data provided to the Architect by the
Contractor. The Contractor shall
maintain the accuracy and/or
completeness of this information and
shall not alter, delete, or otherwise
incorporated herein as a result.

© Copyright 2004 The LKA Partners, Inc. This document and
the information contained herein may not be reproduced or
transmitted in any form or by any means, electronic, mechanical,
photocopying, recording, or by any information storage and
retrieval system, without the prior written permission of
The LKA Partners, Inc. The information herein is provided for
information only and is not intended for construction.

**Elementary
School No. 9**



CEI CONSULTING
ELECTRICAL ENGINEERING
1770 Chapel Hills Drive
Colorado Springs, CO 80920
Telephone: (719) 584-0022
Facsimile: (719) 584-0536

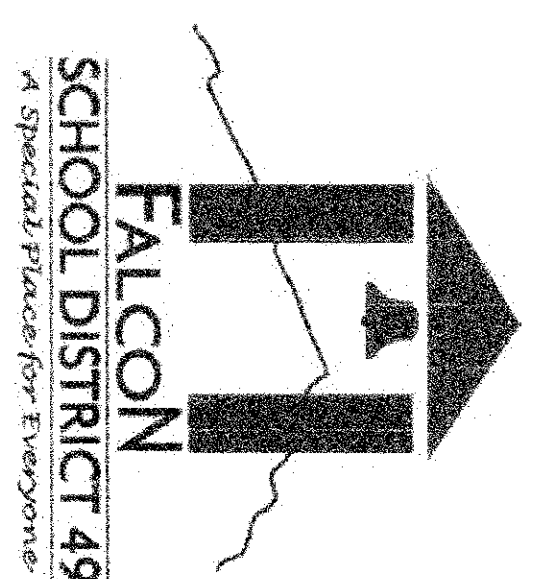

Falcon
School District 49
10850 E. Woodmen Road
Falcon, Colorado 80831

RECORD DRAWINGS

Drawn:
Checked:
Issued: 10/22/04
Revised: Record Drawings 12/1/06
Area Key Plan

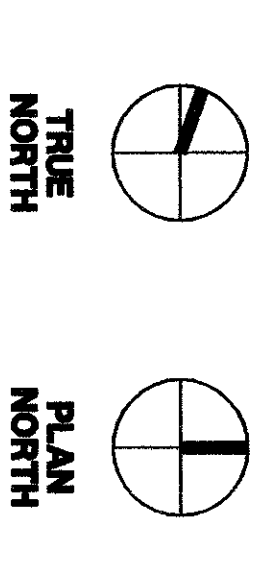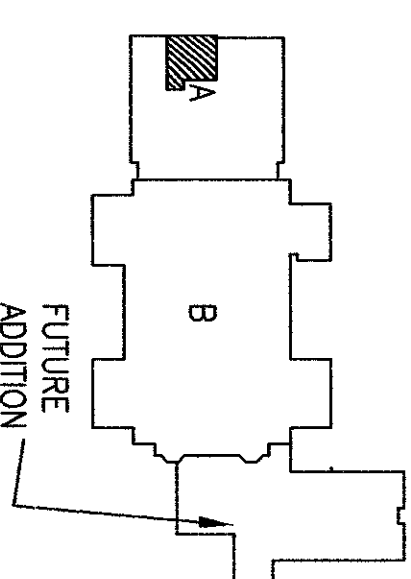


**KITCHEN
POWER PLAN**

Scale 1/8" = 1'-0"

E-2.3

THESE RECORD DRAWINGS HAVE BEEN PREPARED BASED ON INFORMATION
PROVIDED BY OTHERS. THE CONSULTANT HAS NOT VERIFIED THE ACCURACY
AND/OR COMPLETENESS OF THIS INFORMATION AND SHALL NOT BE
RESPONSIBLE FOR ANY ERRORS OR OMISSIONS. THE CONSULTANT HAS
AS A RESULT OF ERRONEOUS INFORMATION PROVIDED BY OTHERS.

- DRAWING NOTES:
- ▷ INSTALL AND WIRE HEAT TRAPE PROVIDED BY FURNISHING CONTRACTOR FOR WALK-IN REFRIGERATOR DRAINS.
 - ▷ INSTALL AND WIRE LUMINAIRES FINISHED WITH WALK-IN BOXES.
 - ▷ UNDER AND ALTERNATE #4, CONNECT TO EMERGENCY CIRCUIT
 - ▷ CONNECT VIA CONTROL PANEL, COORDINATE WITH MECHANICAL CONTRACTOR.

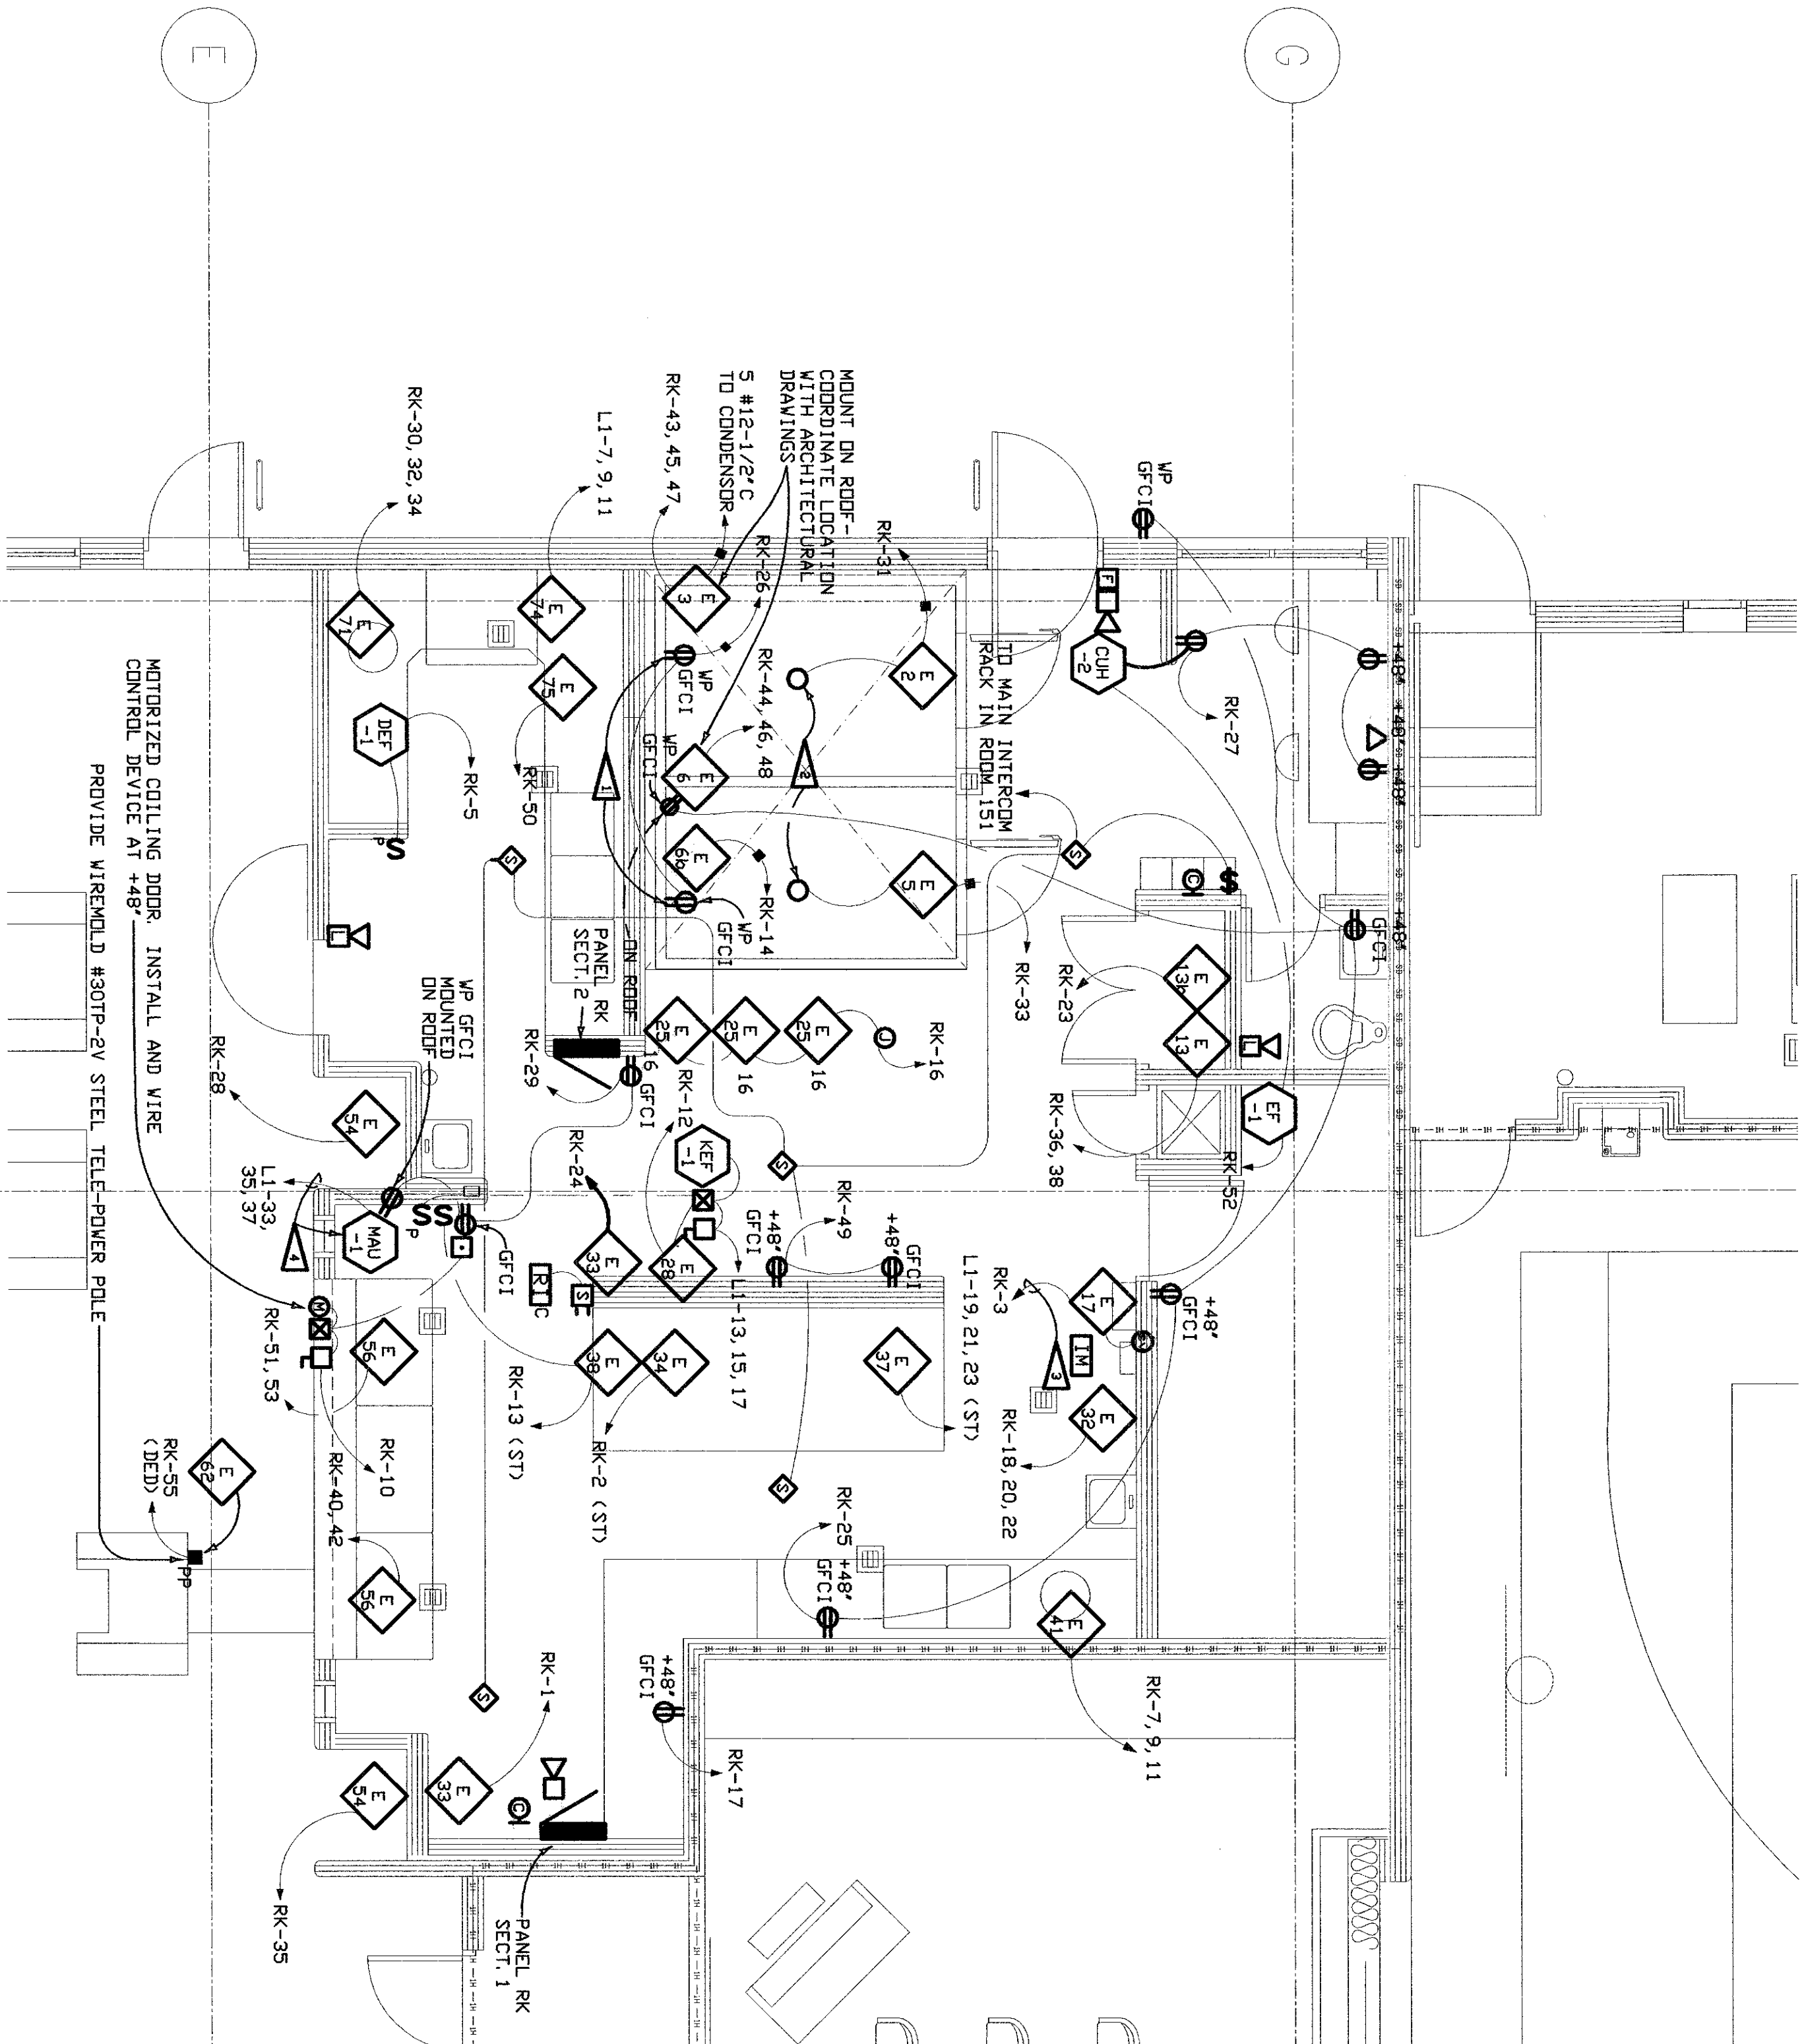

KITCHEN POWER PLAN

SCALE 1/4" = 1'-0"

SCHEDULE OF MECHANICAL EQUIPMENT									
LOAD		VOLTAGE - PHASE (V-PH)		BRANCH CIRCUIT					
HP	KW	A	D	F	208V-3PH	240V-3PH	480V-3PH	400V-3PH	
W	W	B	C	E	G	H	I	J	
WATER LOAD AMPS									
WATER LOAD AMPS									
WATER									