


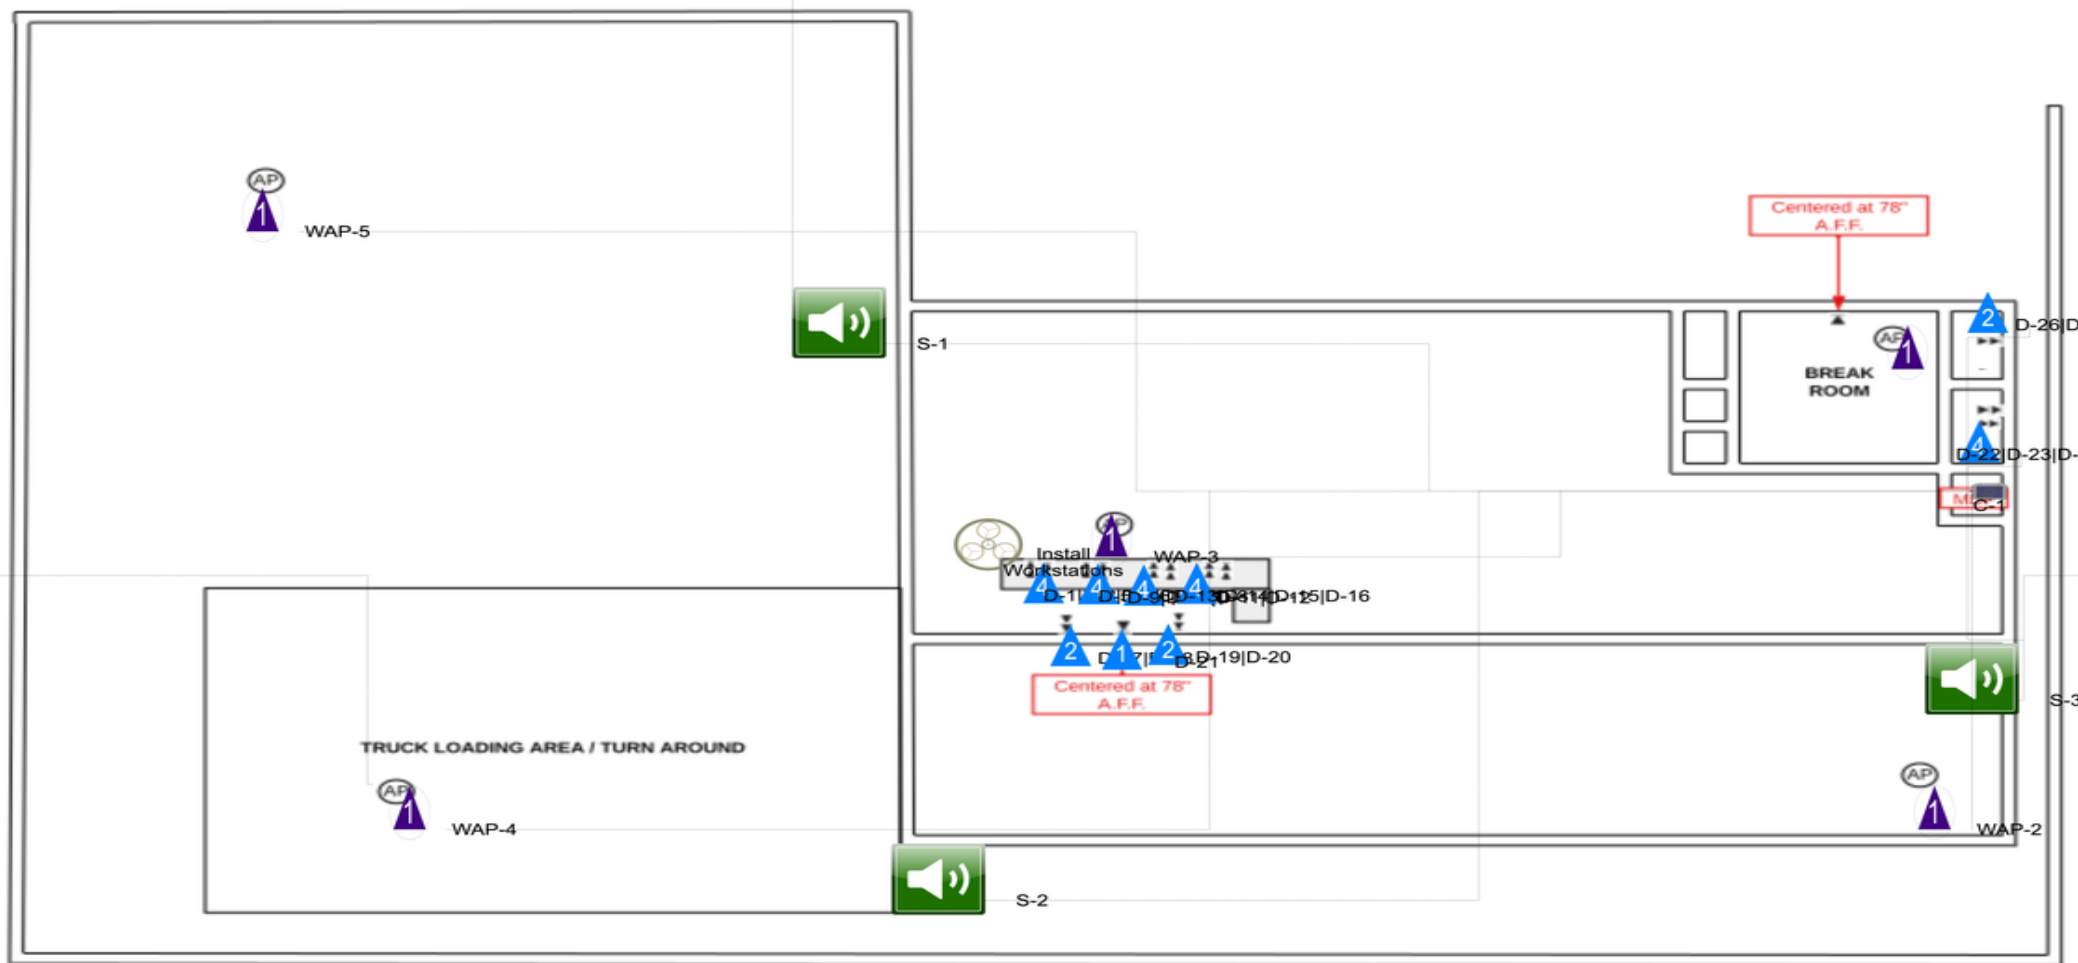

CONFIDENTIAL - NOT TO BE SHARED

AS BUILT
SCALE: NTS