


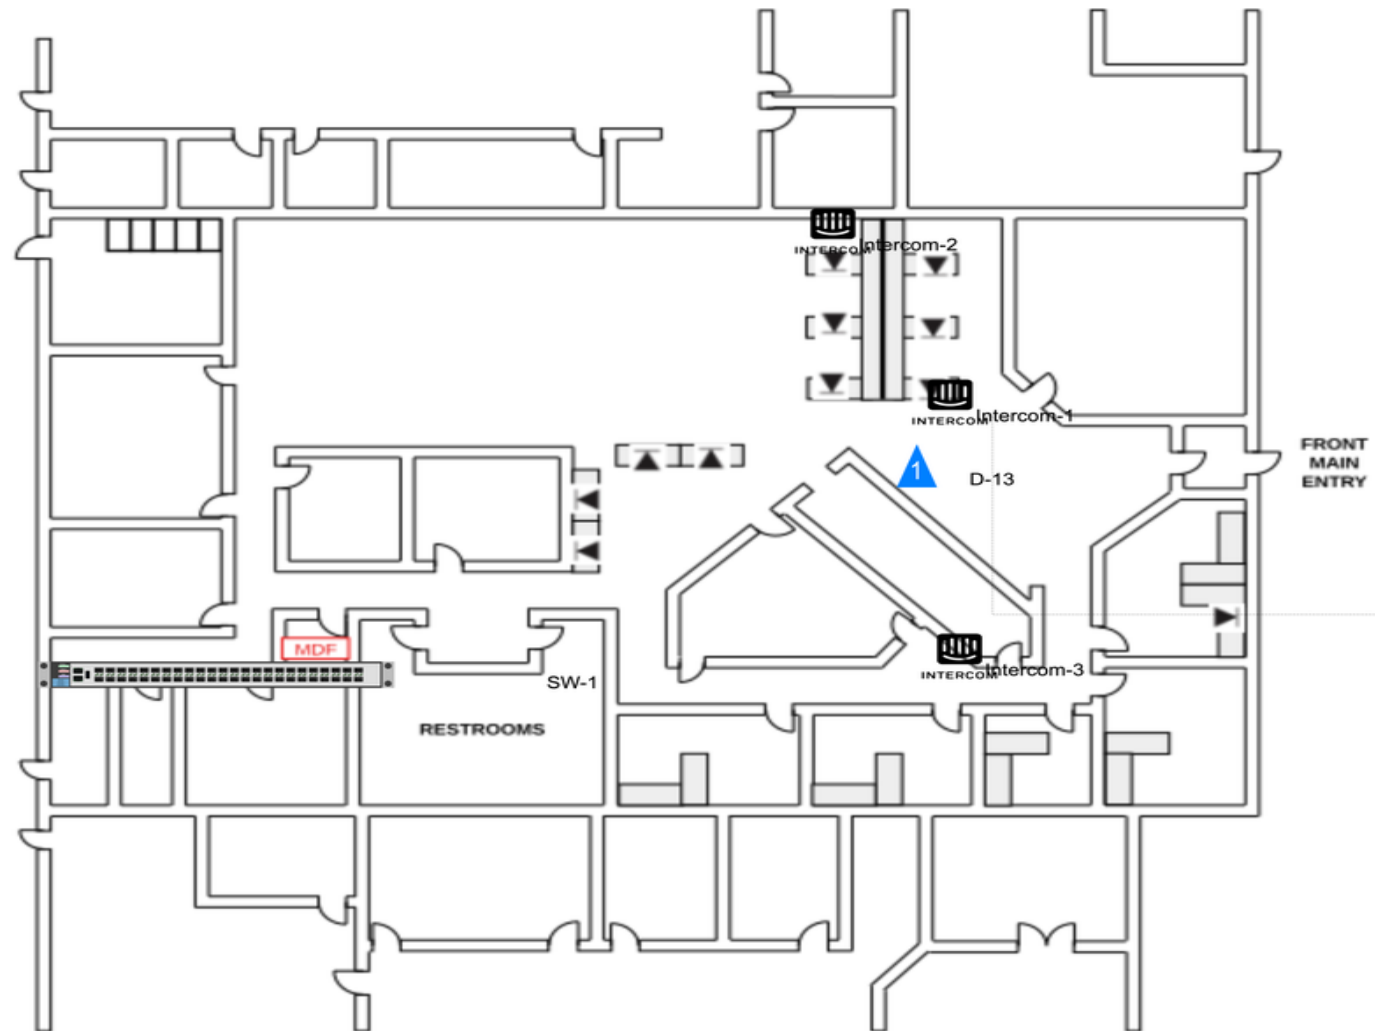

AS BUILT
SCALE: NTS

CONFIDENTIAL - NOT TO BE SHARED