

















 



	Single Data Drop
	Dual Data Drop
	Triple Data Drop
	Quad Data Drop
	Fiber Panel
	Minimum Point of Entry (Carrier MPOE)
	Main Distribution Frame
	Independent Distribution Frame
	Ceiling Mounted Data Drop
	IT Rack Location

	Directional Camera
	Omni Directional Camera
	Horn
	Junction Box
	Television
	Card Reader
	Wireless Access Point
	Ground Bus Bar
A.F.F.	Above Finished Floor
	Conduit
	OS2 Fiber
	OM4 Fiber
	OM3 Fiber
	CAT6

NATIONWIDE SCS

34 MAIN ST EXT

SUITE 304

PLYMOUTH MA

02360

LEGEND

NOTE:

DRAWINGS, SYMBOLS
AND/OR ANNOTATIONS
MAY NOT BE TO SCALE,
AND ARE PORTRAYED
FOR REPRESENTATIONAL
PURPOSES ONLY.
ACTUAL SIZES AND/OR
DESIGN MAY DIFFER.

REVIEWED BY:

CRIS PHELPS, PMP, RCDD

Bicsi

CRIS A. PHELPS

BICS1 ID # 248229

EXPIRES 12-31-25

REGISTERED COMMUNICATIONS DISTRIBUTION DESIGNER

RCDD

LEGEND

SCALE: NTS



NATIONWIDE SCS

34 MAIN ST EXT
SUITE 304
PLYMOUTH MA
02360

SITE PLAN

NOTE:
DRAWINGS, SYMBOLS
AND/OR ANNOTATIONS
MAY NOT BE TO SCALE,
AND ARE PORTRAYED
FOR REPRESENTATIONAL
PURPOSES ONLY.
ACTUAL SIZES AND/OR
DESIGN MAY DIFFER.

REVIEWED BY:
CRIS PHELPS, PMP, RCDD

Bicsi

Cris A Phelps


BICS ID # 248229

Expires 12-31-25

RCDD

SITE PLAN

SCALE: NTS

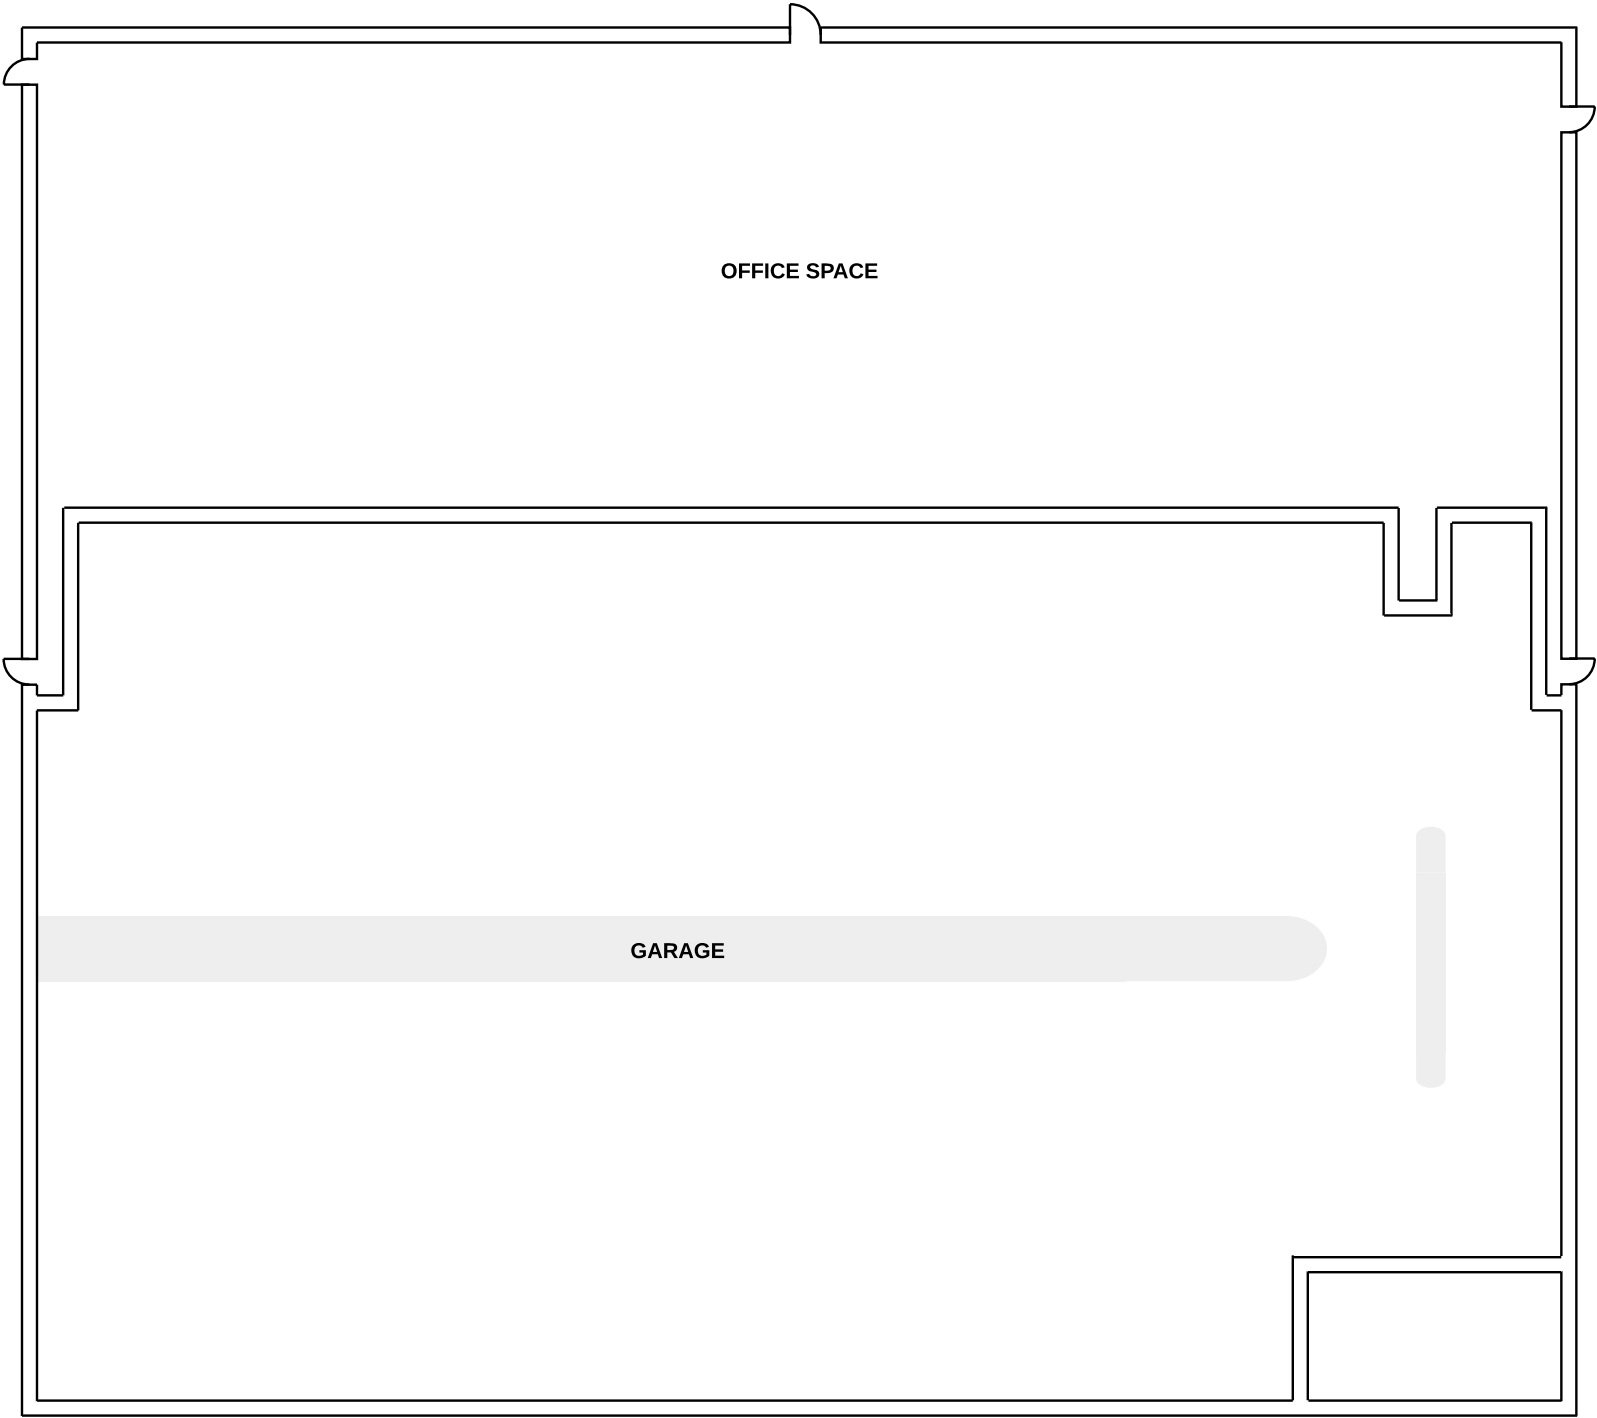

AS BUILT

SCALE: NTS

NATIONWIDE SCS

34 MAIN ST EXT
SUITE 304
PLYMOUTH MA
02360

Revision History

WAREHOUSE AS BUILT / LABELING



NOTE:

DRAWINGS, SYMBOLS
AND/OR ANNOTATIONS
MAY NOT BE TO SCALE,
AND ARE PORTRAYED
FOR REPRESENTATIONAL
PURPOSES ONLY.
ACTUAL SIZES AND/OR
DESIGN MAY DIFFER.

REVIEWED BY:

CRIS PHELPS, PMP, RCDD
(617) 500 - 1252



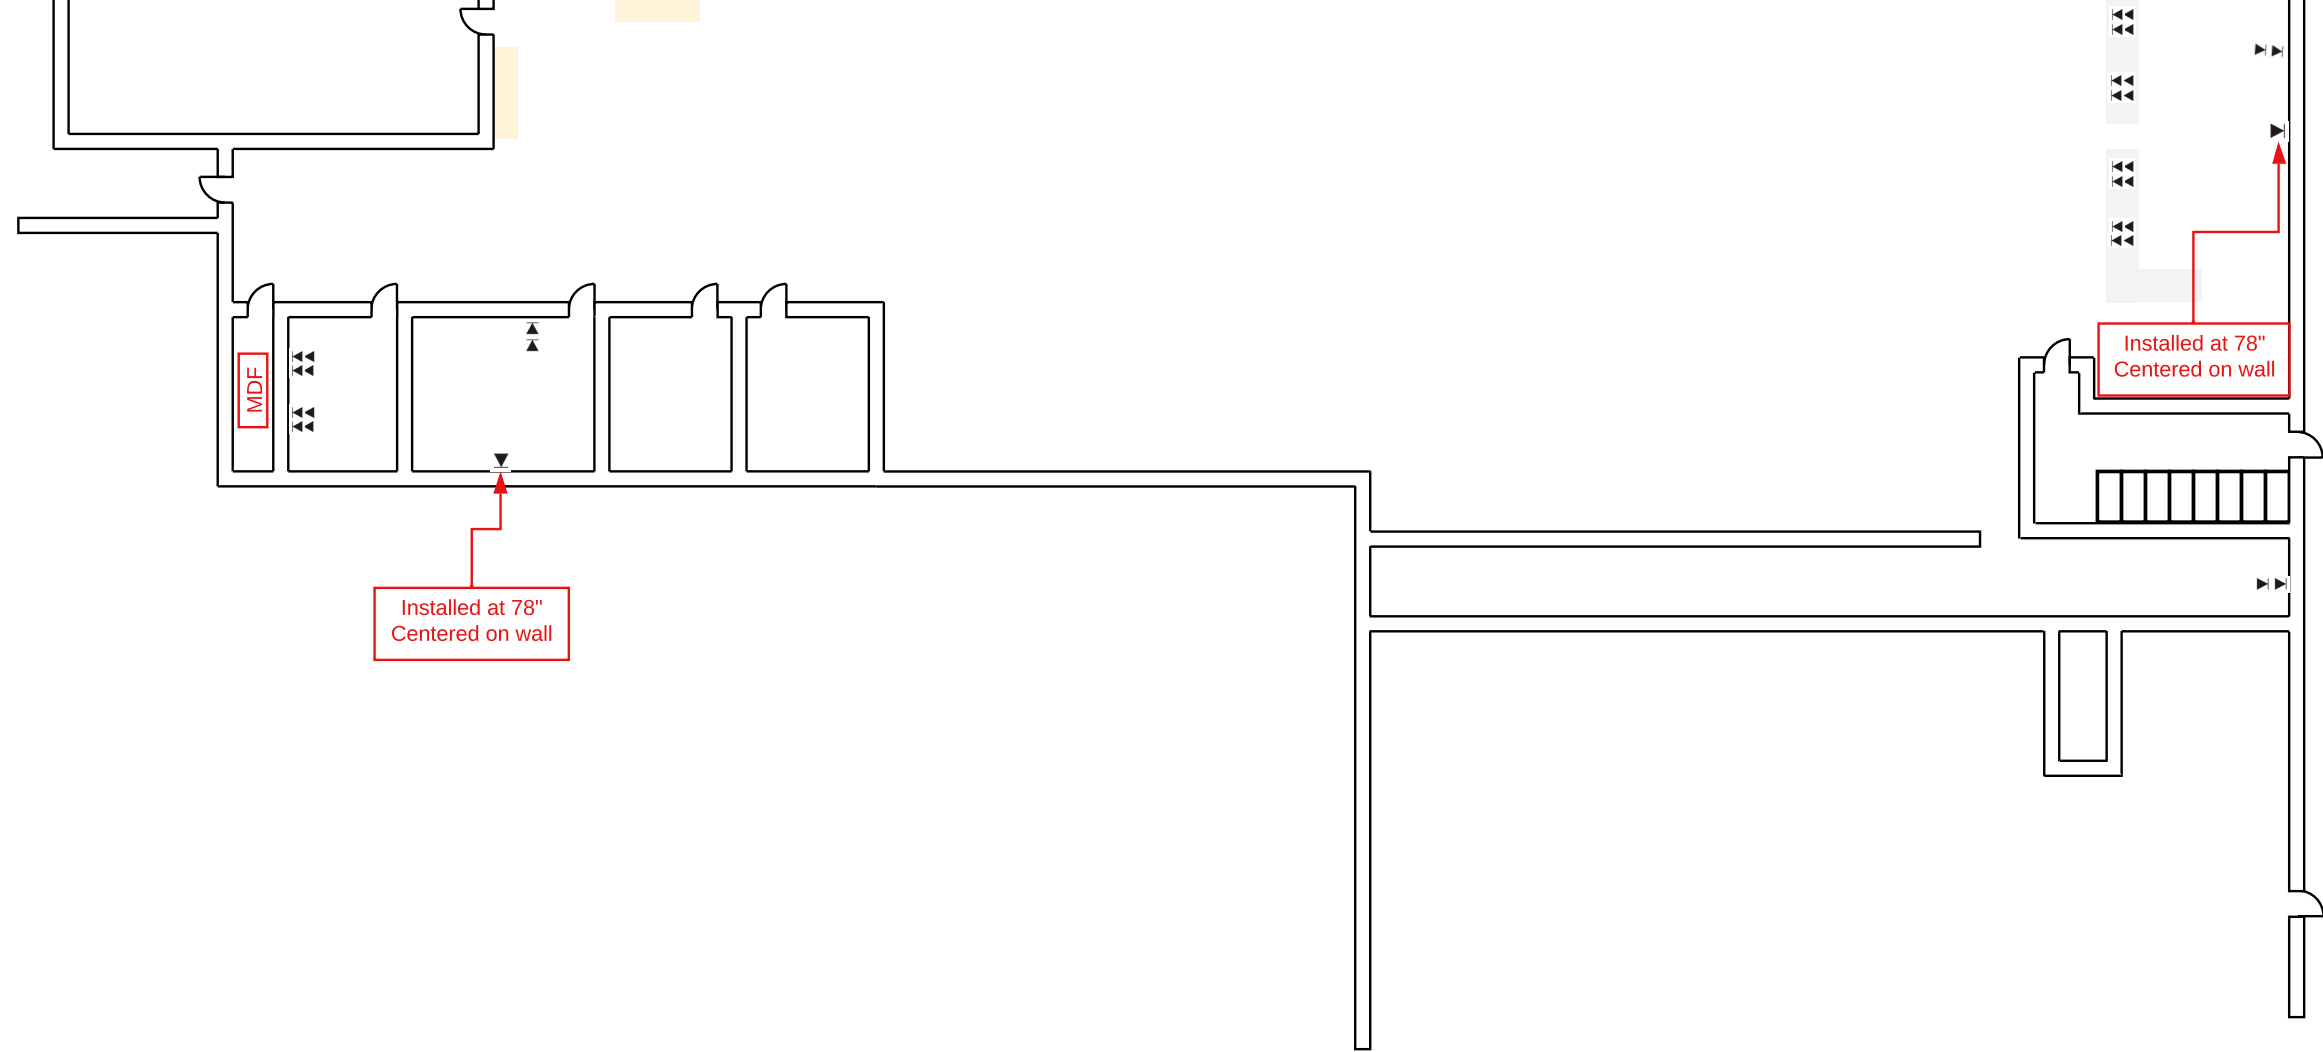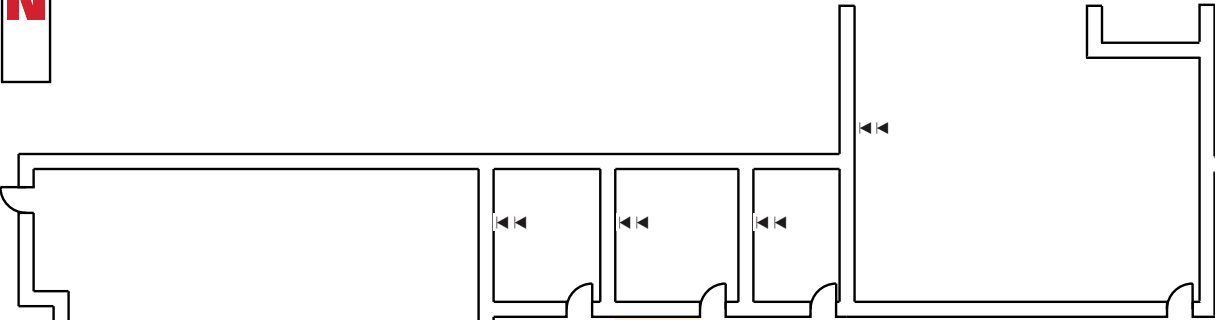

NATIONWIDE SCS

34 MAIN ST EXT

SUITE 304

PLYMOUTH MA

02360

Revision History

AS BUILT / LABELING

NOTE:

DRAWINGS, SYMBOLS
AND/OR ANNOTATIONS
MAY NOT BE TO SCALE,
AND ARE PORTRAYED
FOR REPRESENTATIONAL
PURPOSES ONLY.
ACTUAL SIZES AND/OR
DESIGN MAY DIFFER.

REVIEWED BY:

CRIS PHELPS, PMP, RCDD
(617) 500 - 1252

REGISTERED COMMUNICATIONS DISTRIBUTION DESIGNER

Bicsi

CRIS A. Phelps

BICS ID # 248229

Expires 12-31-25

RCDD

AS BUILT

SCALE: NTS



NATIONWIDE SCS
34 MAIN ST EXT
SUITE 304
PLYMOUTH MA
02360

CUSTOMER PROVIDED OFFICE FLOOR PLAN
FIRST FLOOR

NOTE:
DRAWINGS, SYMBOLS
AND/OR ANNOTATIONS
MAY NOT BE TO SCALE,
AND ARE PORTRAYED
FOR REPRESENTATIONAL
PURPOSES ONLY.
ACTUAL SIZES AND/OR
DESIGN MAY DIFFER.

REVIEWED BY:
CRIS PHELPS, PMP, RCDD

RCDD



CUSTOMER PROVIDED FLOOR PLAN

SCALE: NTS



Main Floor Plan

