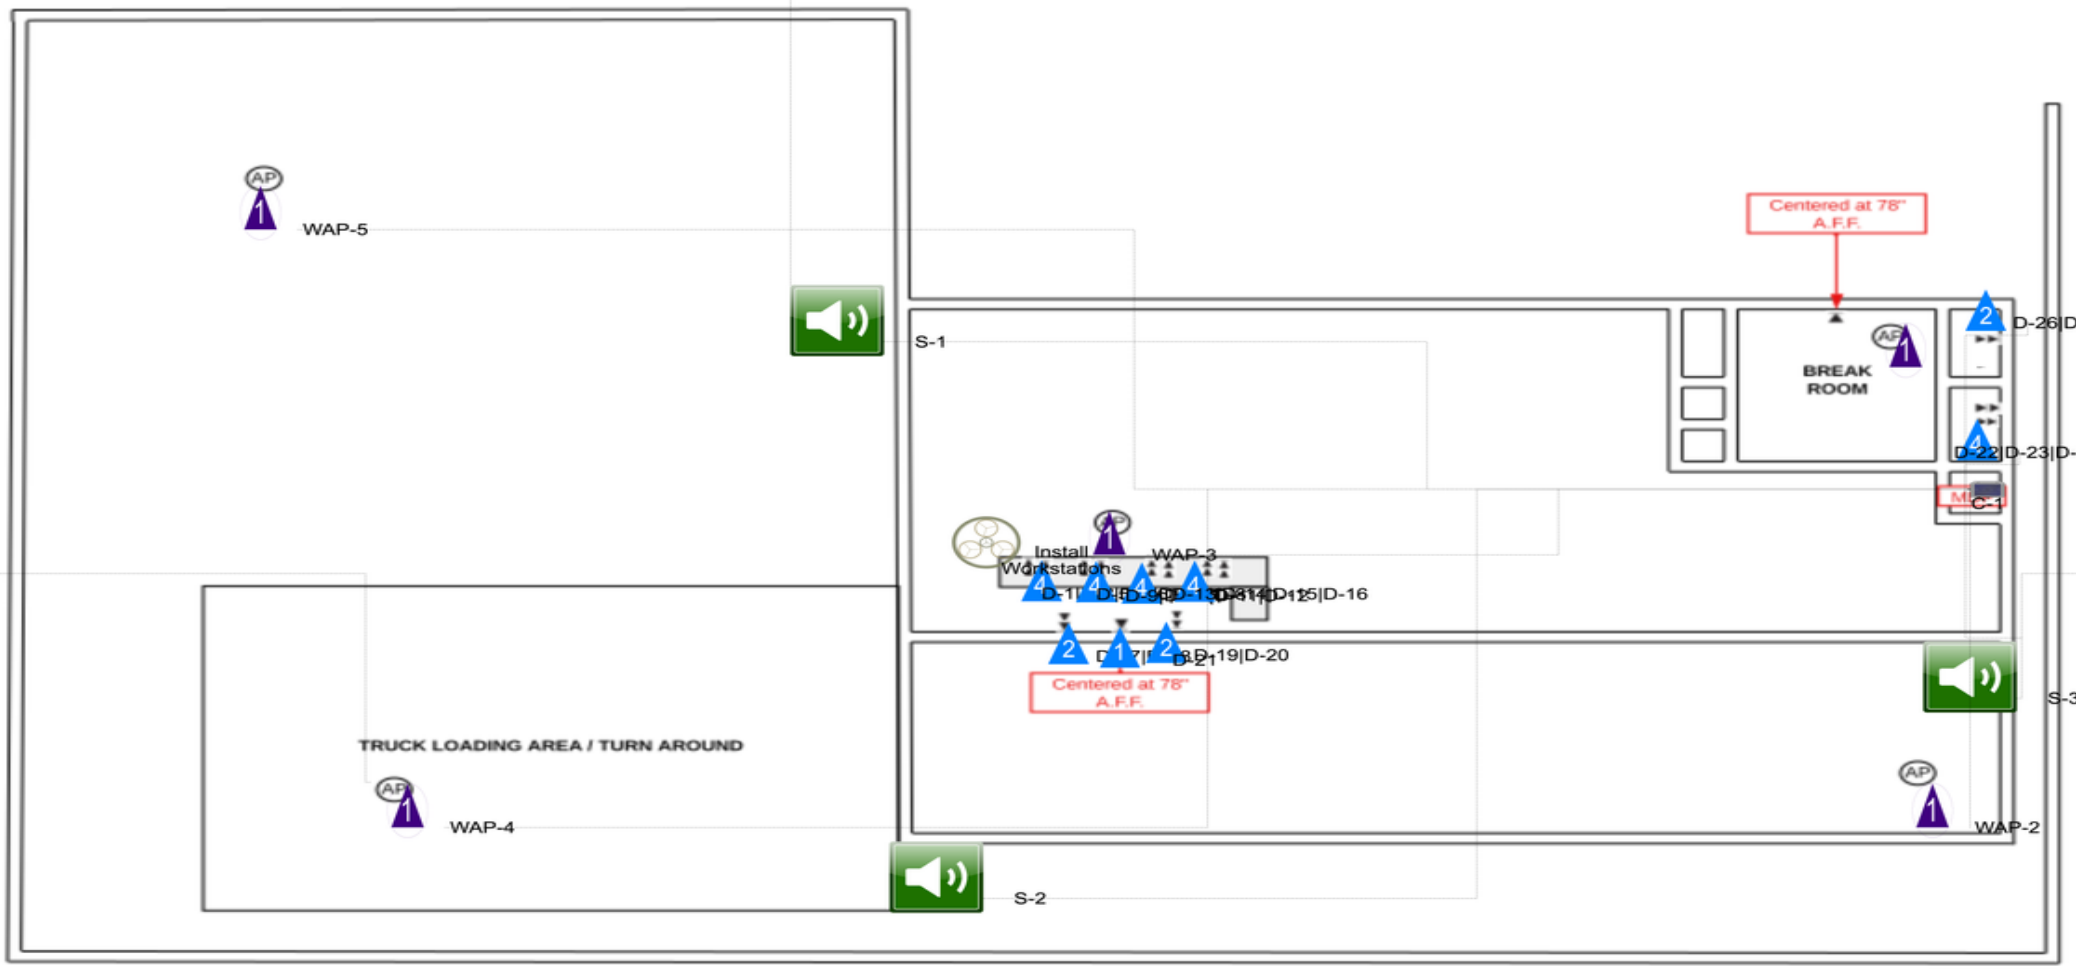

AS BUILT

SCALE: NTS

CONFIDENTIAL - NOT TO BE SHARED